


SCALE 1" = 150'

Surveying Colorado Since 1972

FAX: (303) 761-0841

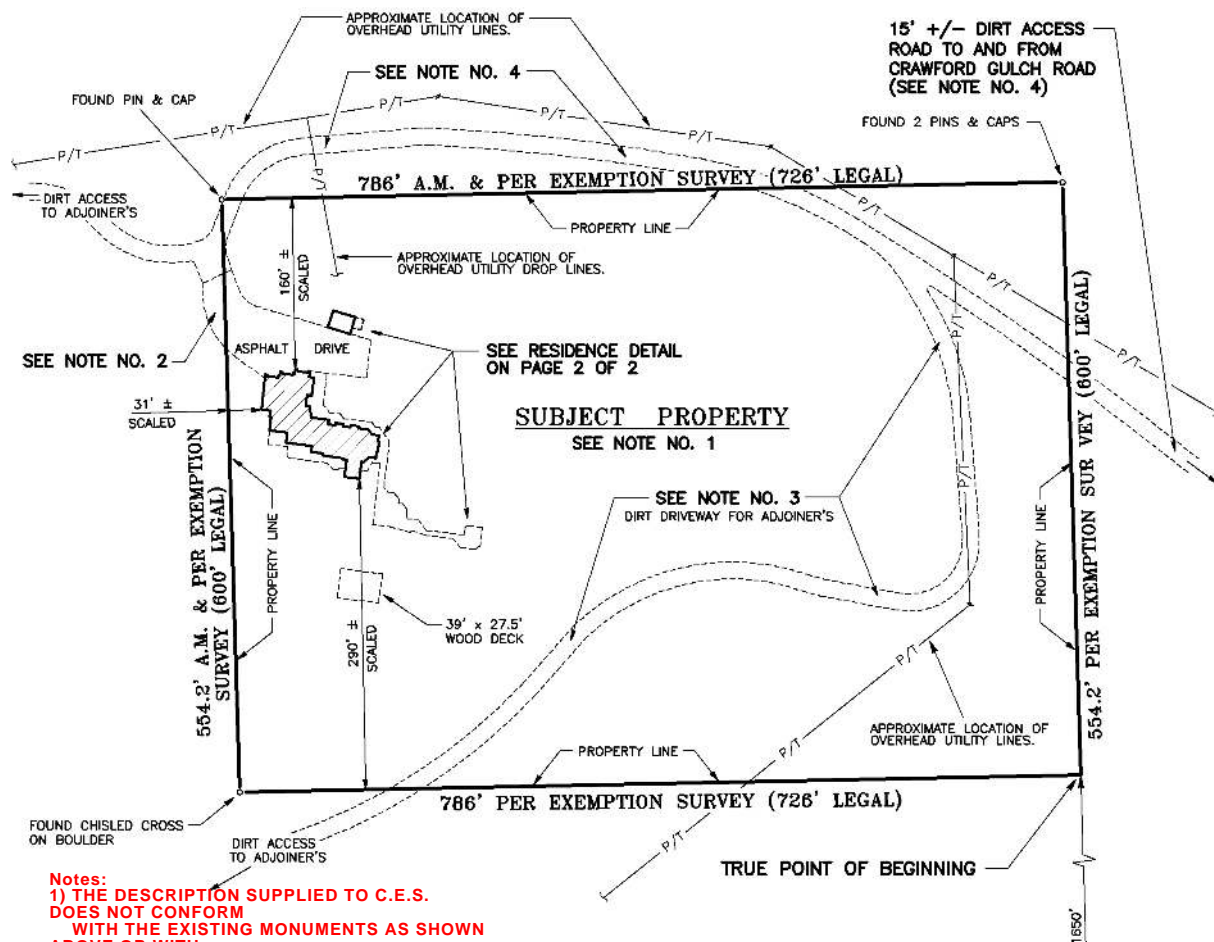

Notes:

- 1) THE DESCRIPTION SUPPLIED TO C.E.S.
DOES NOT CONFORM
WITH THE EXISTING MONUMENTS AS SHOWN
ABOVE OR WITH
THE EXEMPTION SURVEY FILED WITH
JEFFERSON COUNTY.
- 2) ASPHALT DRIVEWAY ENCLOSES OFF OF
SUBJECT PROPERTY AND INTO ADJOINING
PARCEL TO THE WEST
AS SHOWN.
- 3) DIRT DRIVEWAY FOR ADJOINER'S TO THE
SOUTH CROSSES
OVER SUBJECT PROPERTY FOR ACCESS TO
AND FROM
CRAWFORD GULCH ROAD AS SHOWN.
- 4) EXISTING DIRT ACCESS ROAD CROSSES
OVER ADJOINING
PARCELS FOR ACCESS TO AND FROM
CRAWFORD GULCH
ROAD AS SHOWN.

POINT OF COMMENCEMENT

S.E. CORNER OF THE WEST 1/2
OF THE S.W. 1/4 OF SECTION 14
T. 3 S., R. 71 W. OF THE 6TH P.M.



LEGAL DESCRIPTION:

PER TITLE COMMITMENT NO. 25479:

SEE PAGE 2 OF 2

ALSO KNOWN AS 5317 CRAWFORD GULCH RD

CENSUS TRACT	98.08
--------------	-------

FLOOD CERTIFICATION

FLOOD CERTIFICATION
This community does participate in the National Flood Insurance Program X

This community does not participate in the National Flood Insurance Program _____

I hereby certify that the property described hereon *** located within a flood hazard boundary, (zone "C"), according to the most current flood insurance rate map (FIRM), produced by the Federal Emergency Management Agency (FEMA).

Flood hazard maps dated August 5, 1986

Community number 080087

Panel number 0150 - B

IMPROVEMENT LOCATION CERTIFICATE

IMPROVEMENT LOCATION CERTIFICATE Client

I hereby certify that this improvement location certificate was prepared for that it is not a land survey plat or improvement survey plat, and that it is not to be relied upon for the establishment of fence, building, or other improvement lines.

Client

I further certify that the improvements on the above described parcel on this date April 19, 2001 except utility connections, are entirely within the boundaries of the parcel, except as shown, that there are no encroachments upon the described premises by improvements on any adjoining premises, except as indicated, and that there is no apparent evidence or sign of any easement crossing or burdening any part said parcel, except as noted.

I further certify that the location of improvements shown hereon are based upon the location of monuments in the area, and that this document does not purport to be an Improvement Survey Plat, and is subject to any inaccuracies that a subsequent Improvement Survey Plat would disclose. The surveyor makes no warranty or representation concerning fences and their location in relation to the boundary lines, unless specifically noted.

Evidence used to determine the apparent deed lines:
As shown and stated on this drawing as "Found", if no monuments were found at the subject property, the apparent deed lines were based upon an analytical correlation between occupation lines, as built improvements (public & private), street right-of-way lines, etc., an Improvement Survey Plat may yield different results.

Record title, Deed and Legal Description:
 This information was supplied to Colorado Engineering & Surveying, Inc.; no title search was conducted by CES.
 All information pertains to deed lines and easements were derived from the recorded plat, unless otherwise noted and stated.
 This document is protected under the laws of the Federal Copyright Act. This drawing shall not be used by the client or any other party for ANY purpose other than that which the drawing was prepared. The absence of RED stamped seal indicates an unauthorized reproduction, and no certification extends to the person holding such copy.

© 2009
COLORADO ENGINEERING AND SURVEYING, INC.

By _____
Date April 20, 2001